


All work to be carried out in accordance with the requirements of the Building Regulations and the Water Authority Regulations currently in force.

Do not scale from this drawing. Architect to be notified of any discrepancies.

Verify relevant dimensions on site before commencing work or preparing shop drawings.

This drawing is copyright.

## NOTES

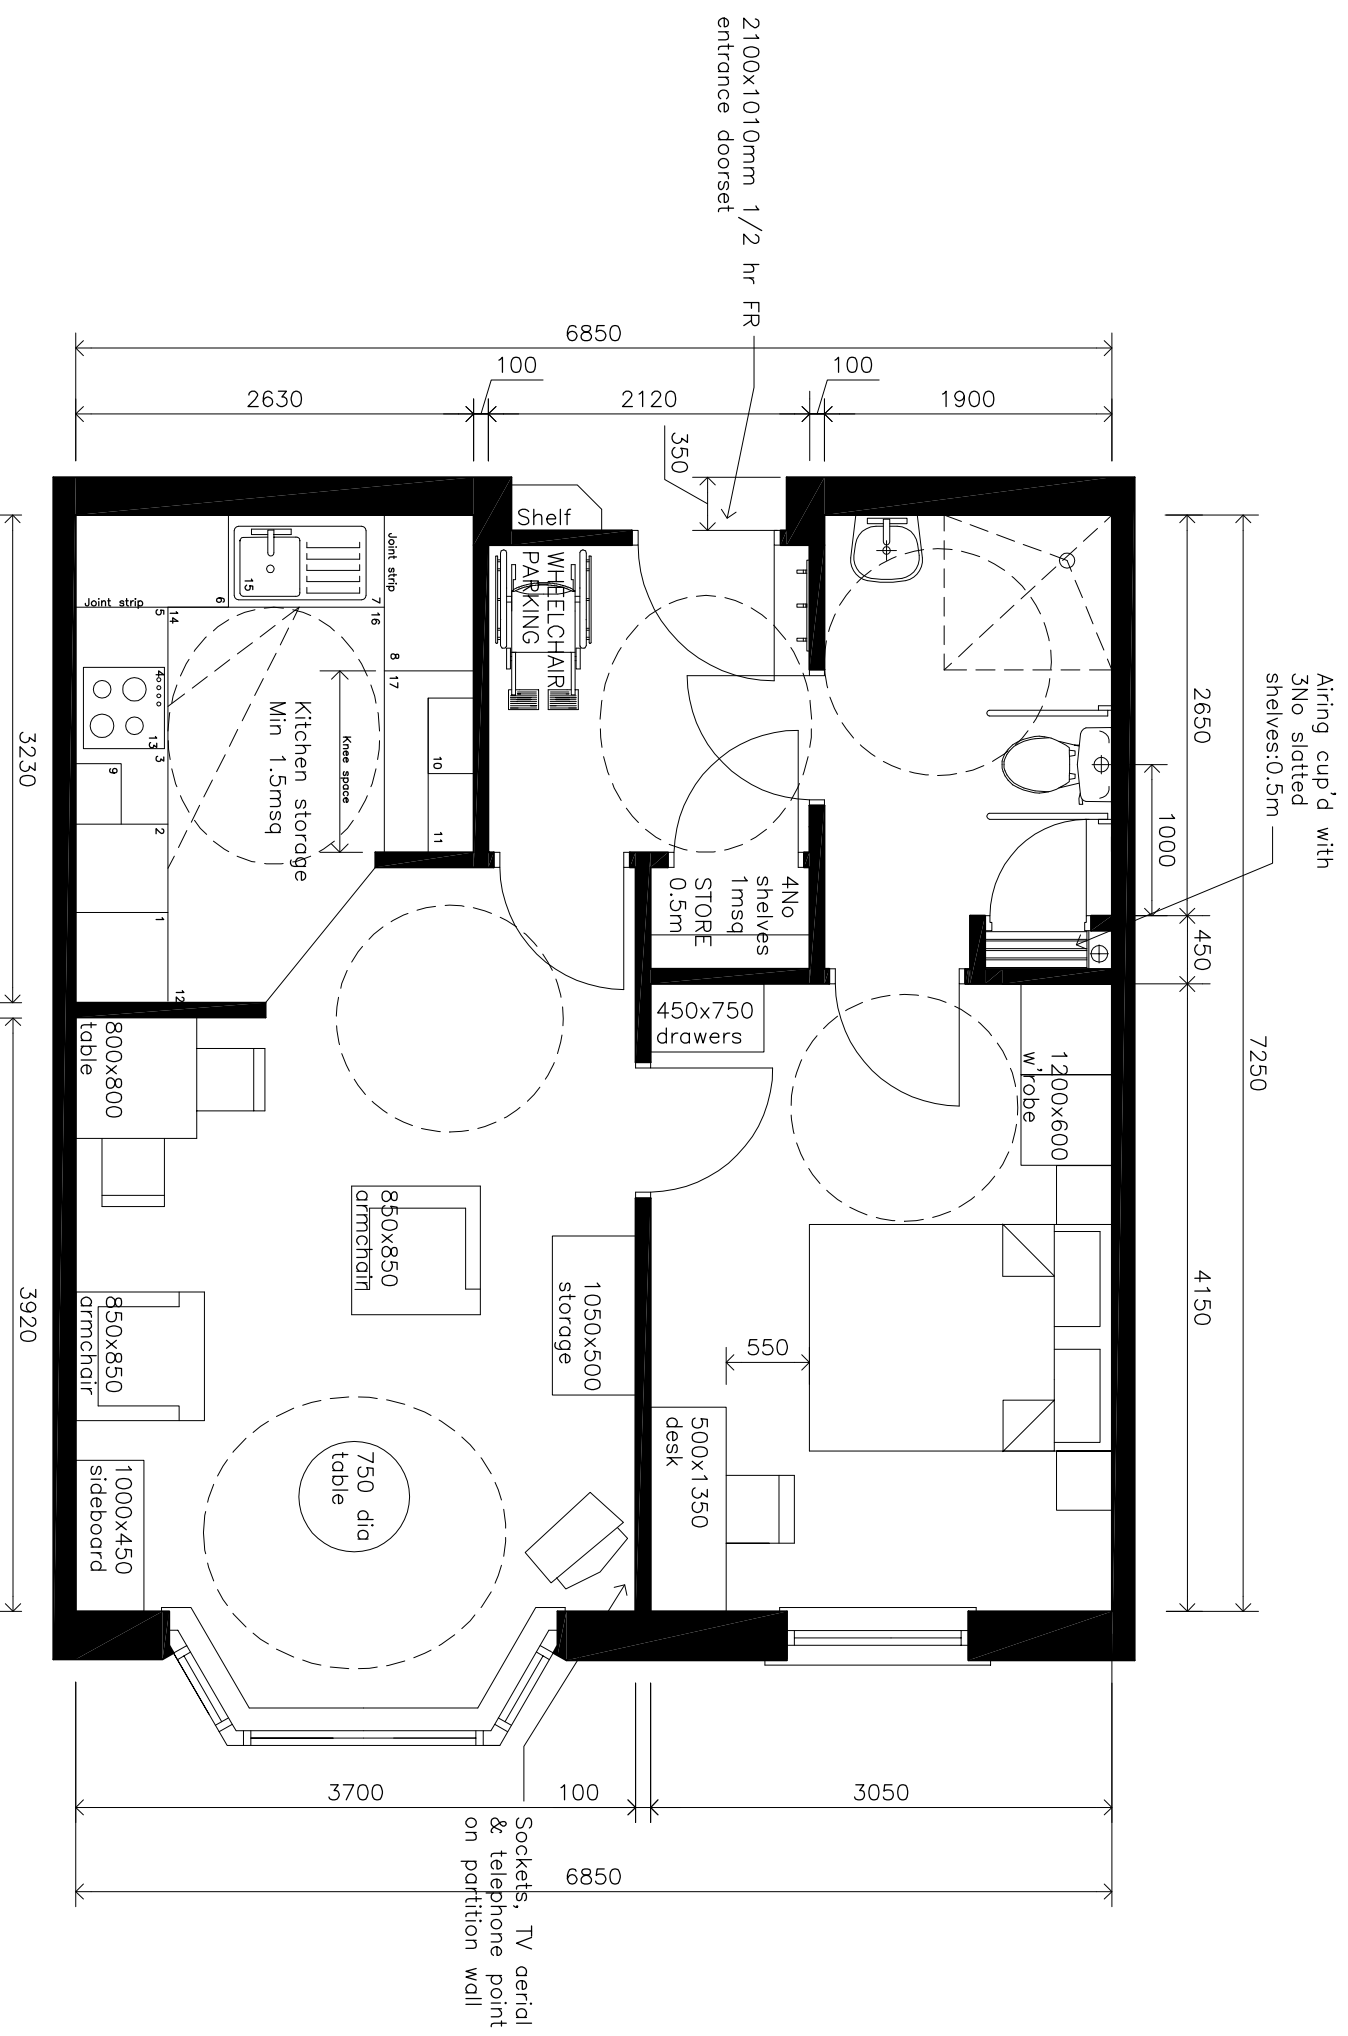

### KITCHEN UNIT SCHEDULE STANDARD DRAWER LINE RANGE

1. 600mm Fridge/freezer housing : 0.05msq
  2. 600mm Oven housing : 0.22msq
  3. 500mm Base unit : 0.19msq
  4. 600mm Base unit : 0.23msq
  5. 300mm Base unit : 0.11msq
  6. 1000mm corner unit : 0.40msq
  7. 1000mm sink unit : 0.40msq
  8. 1000mm corner unit : 0.40msq
  9. 400w x 720h wall unit
  10. 500w x 720h lockable wall unit
  11. 500w x 720h wall unit
  12. Infill panel
  13. 4 ring electric hob
  14. Corner post
  15. Stainless steel inset sink
  16. Corner post
  17. Blanking panel
- 600mm deep x 30mm th post formed worktops  
2230mm, 2030mm & 1430mm lengths.

**APPLEGARTH  
BRIDLINGTON**

**FOR  
HOUSING 21  
1 BED APARTMENT LAYOUT  
STANDARD KITCHEN**

AS BUILT ISSUE

Drawing No. 03079/09 Revision A

Scale 1:50 Date MAY 04 Drawn By PC

**J H LANGTRY - LANGTON PARTNERS  
CHARTERED ARCHITECTS**  
8, OAK MOUNT, BRADPOD BD8 7BD  
TEL - 01274 498226 FAX - 01274 548416  
E Mail - jlangtry@langton.co.uk

