


All work to be carried out in accordance with the Building Regulations and the Building Act 2004, and the Water Authority Regulations currently in force. Do not scale from this drawing. Architect to be notified of any discrepancies. Verify relevant dimensions on site before commencing work on preparing shop drawings. This drawing is copyright.

NOTES

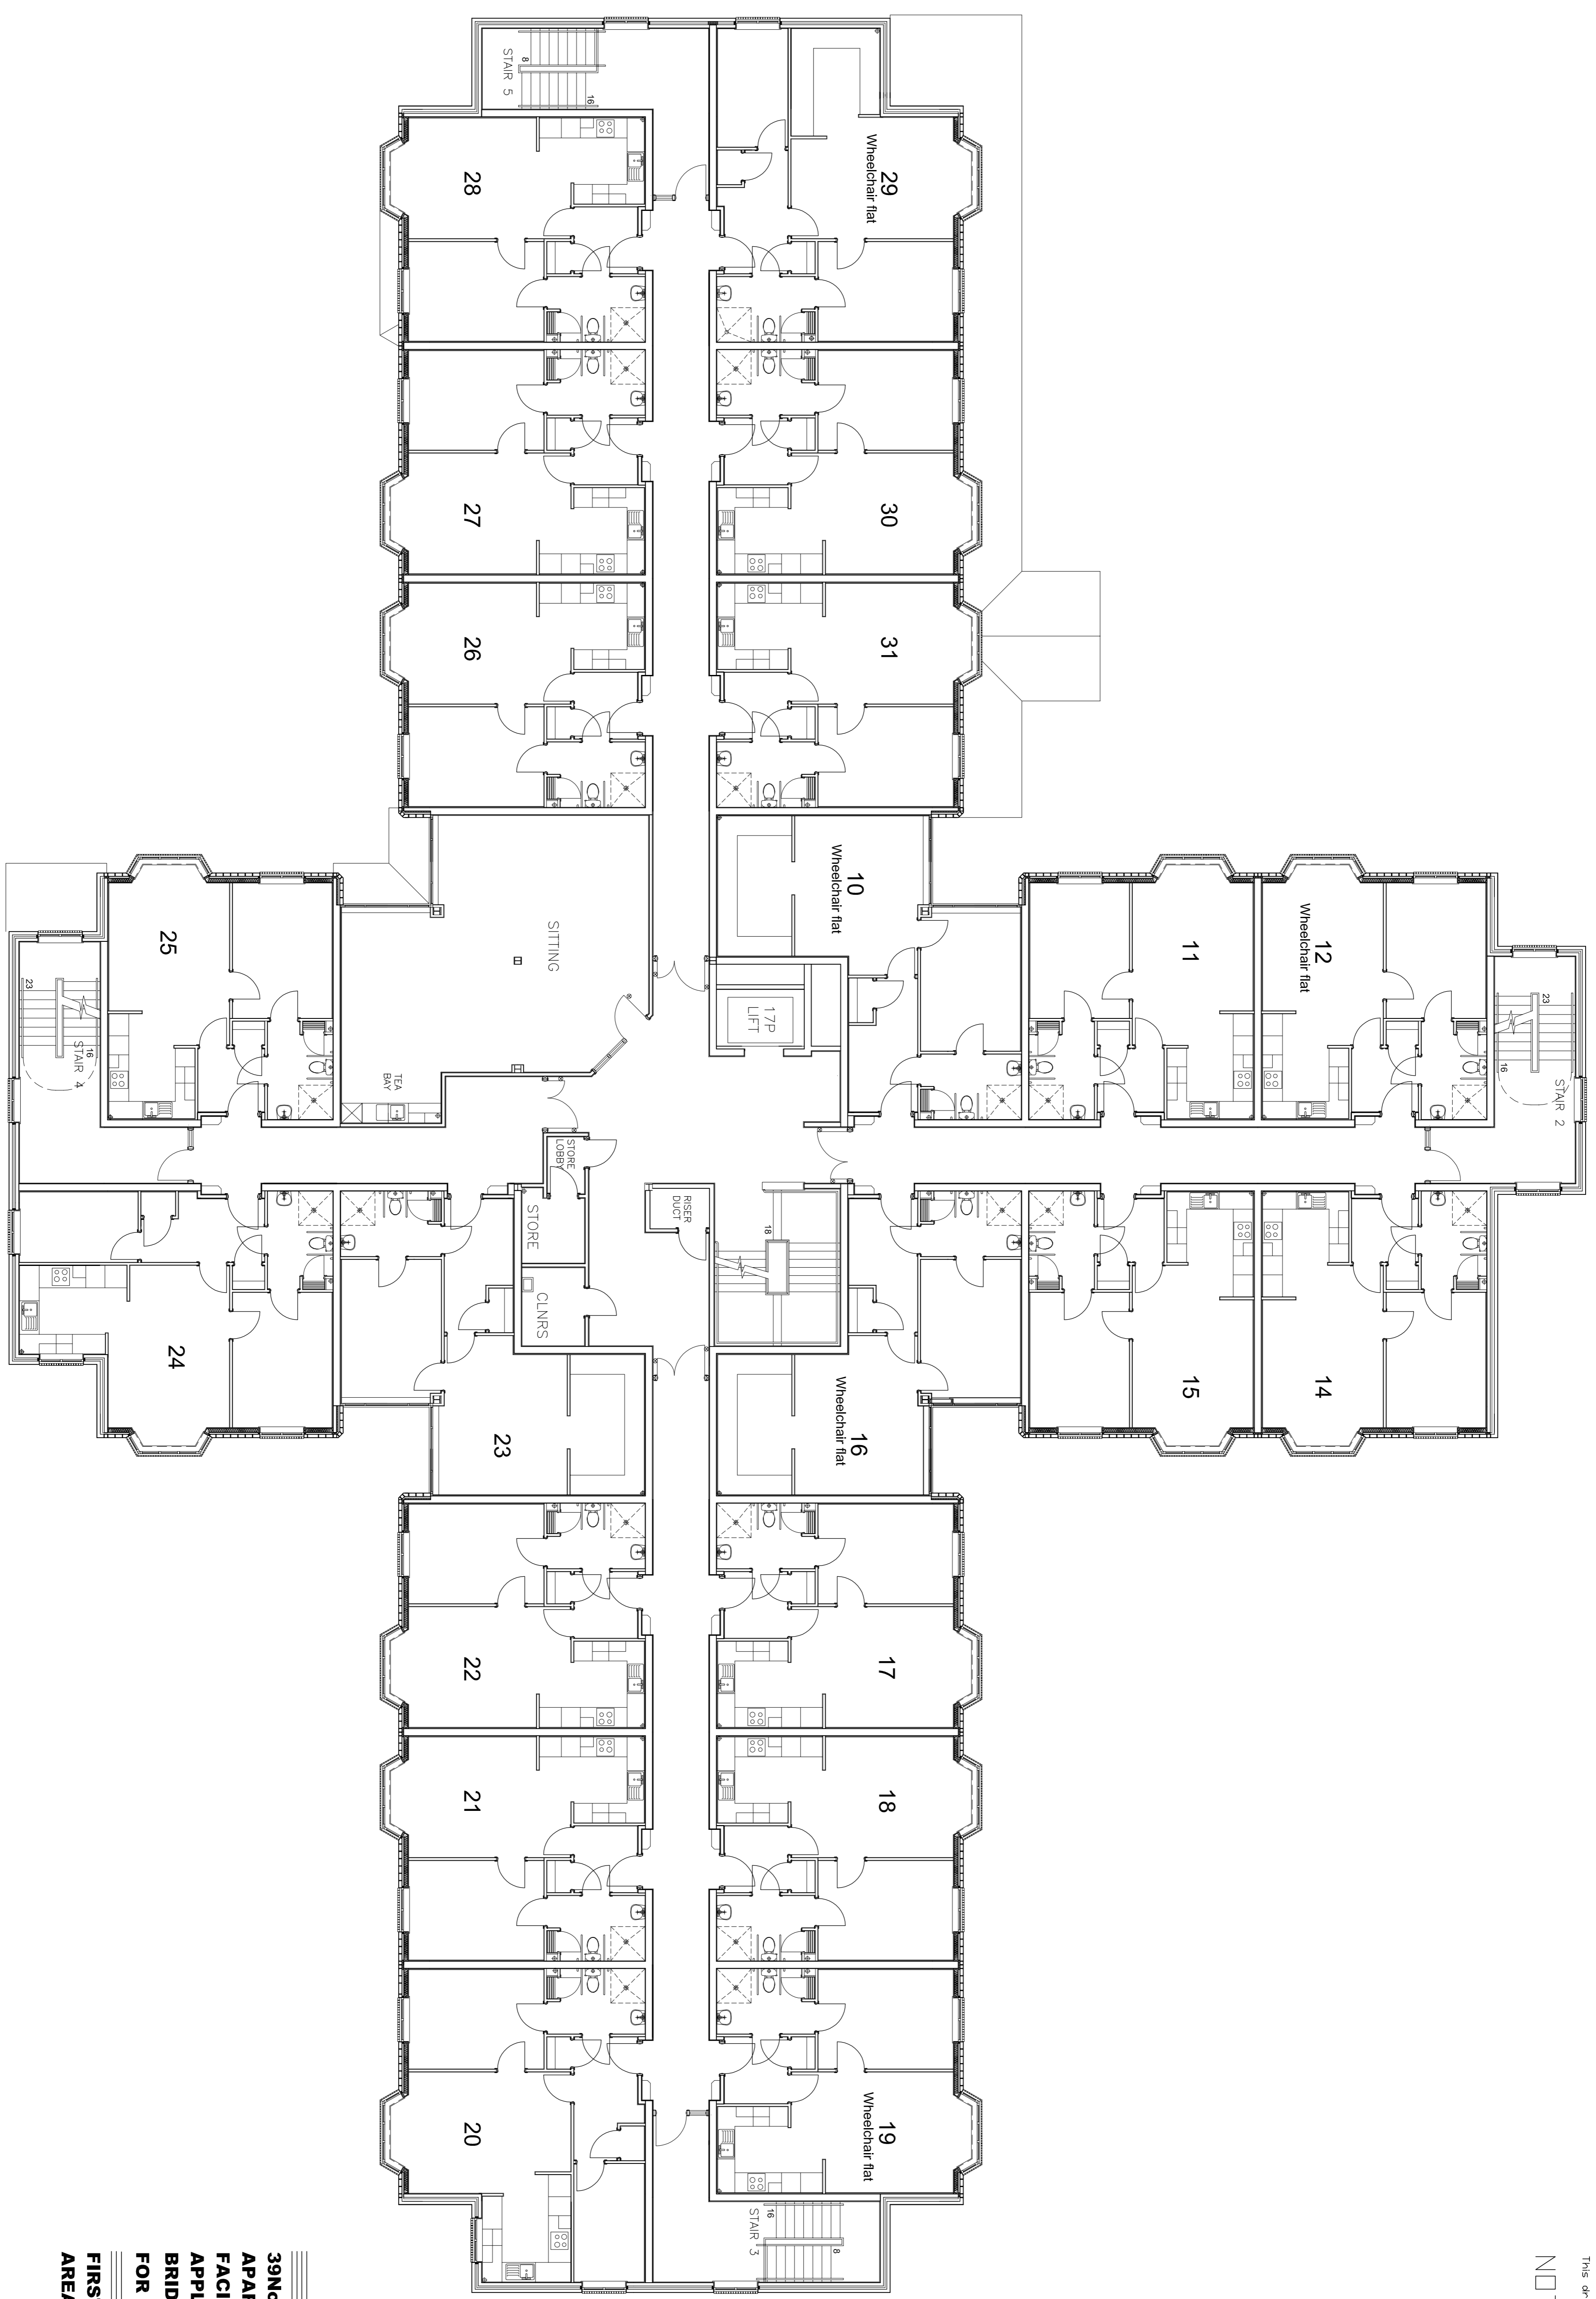

39 No VERY SHELTERED APARTMENTS, COMMUNAL FACILITIES & DAYCARE APPLGARTH LANE BRIDLINGTON FOR : HOUSING 21

FIRST FLOOR PLAN
AREA : 1615msq

AS BUILT ISSUE

Drawing No. 03079/04	Revision G
Scale 1:100	Date AUG 04
Drawn By PG	

J H LANGTRY - LANGTON PARTNERS
CHARTERED ARCHITECTS
 8, OAK HOUNTS, BRADFORD ROAD, BR7 7BD
 BRIDLINGTON, EAST SUSSEX, BN1 1AA
 Email: J.Langtry@langton.co.uk

